


EXISTING WALL MOUNTED FAN COIL UNITS
TO BE REMOVED AND REINSTALLED
RETIRED (TYPICAL)

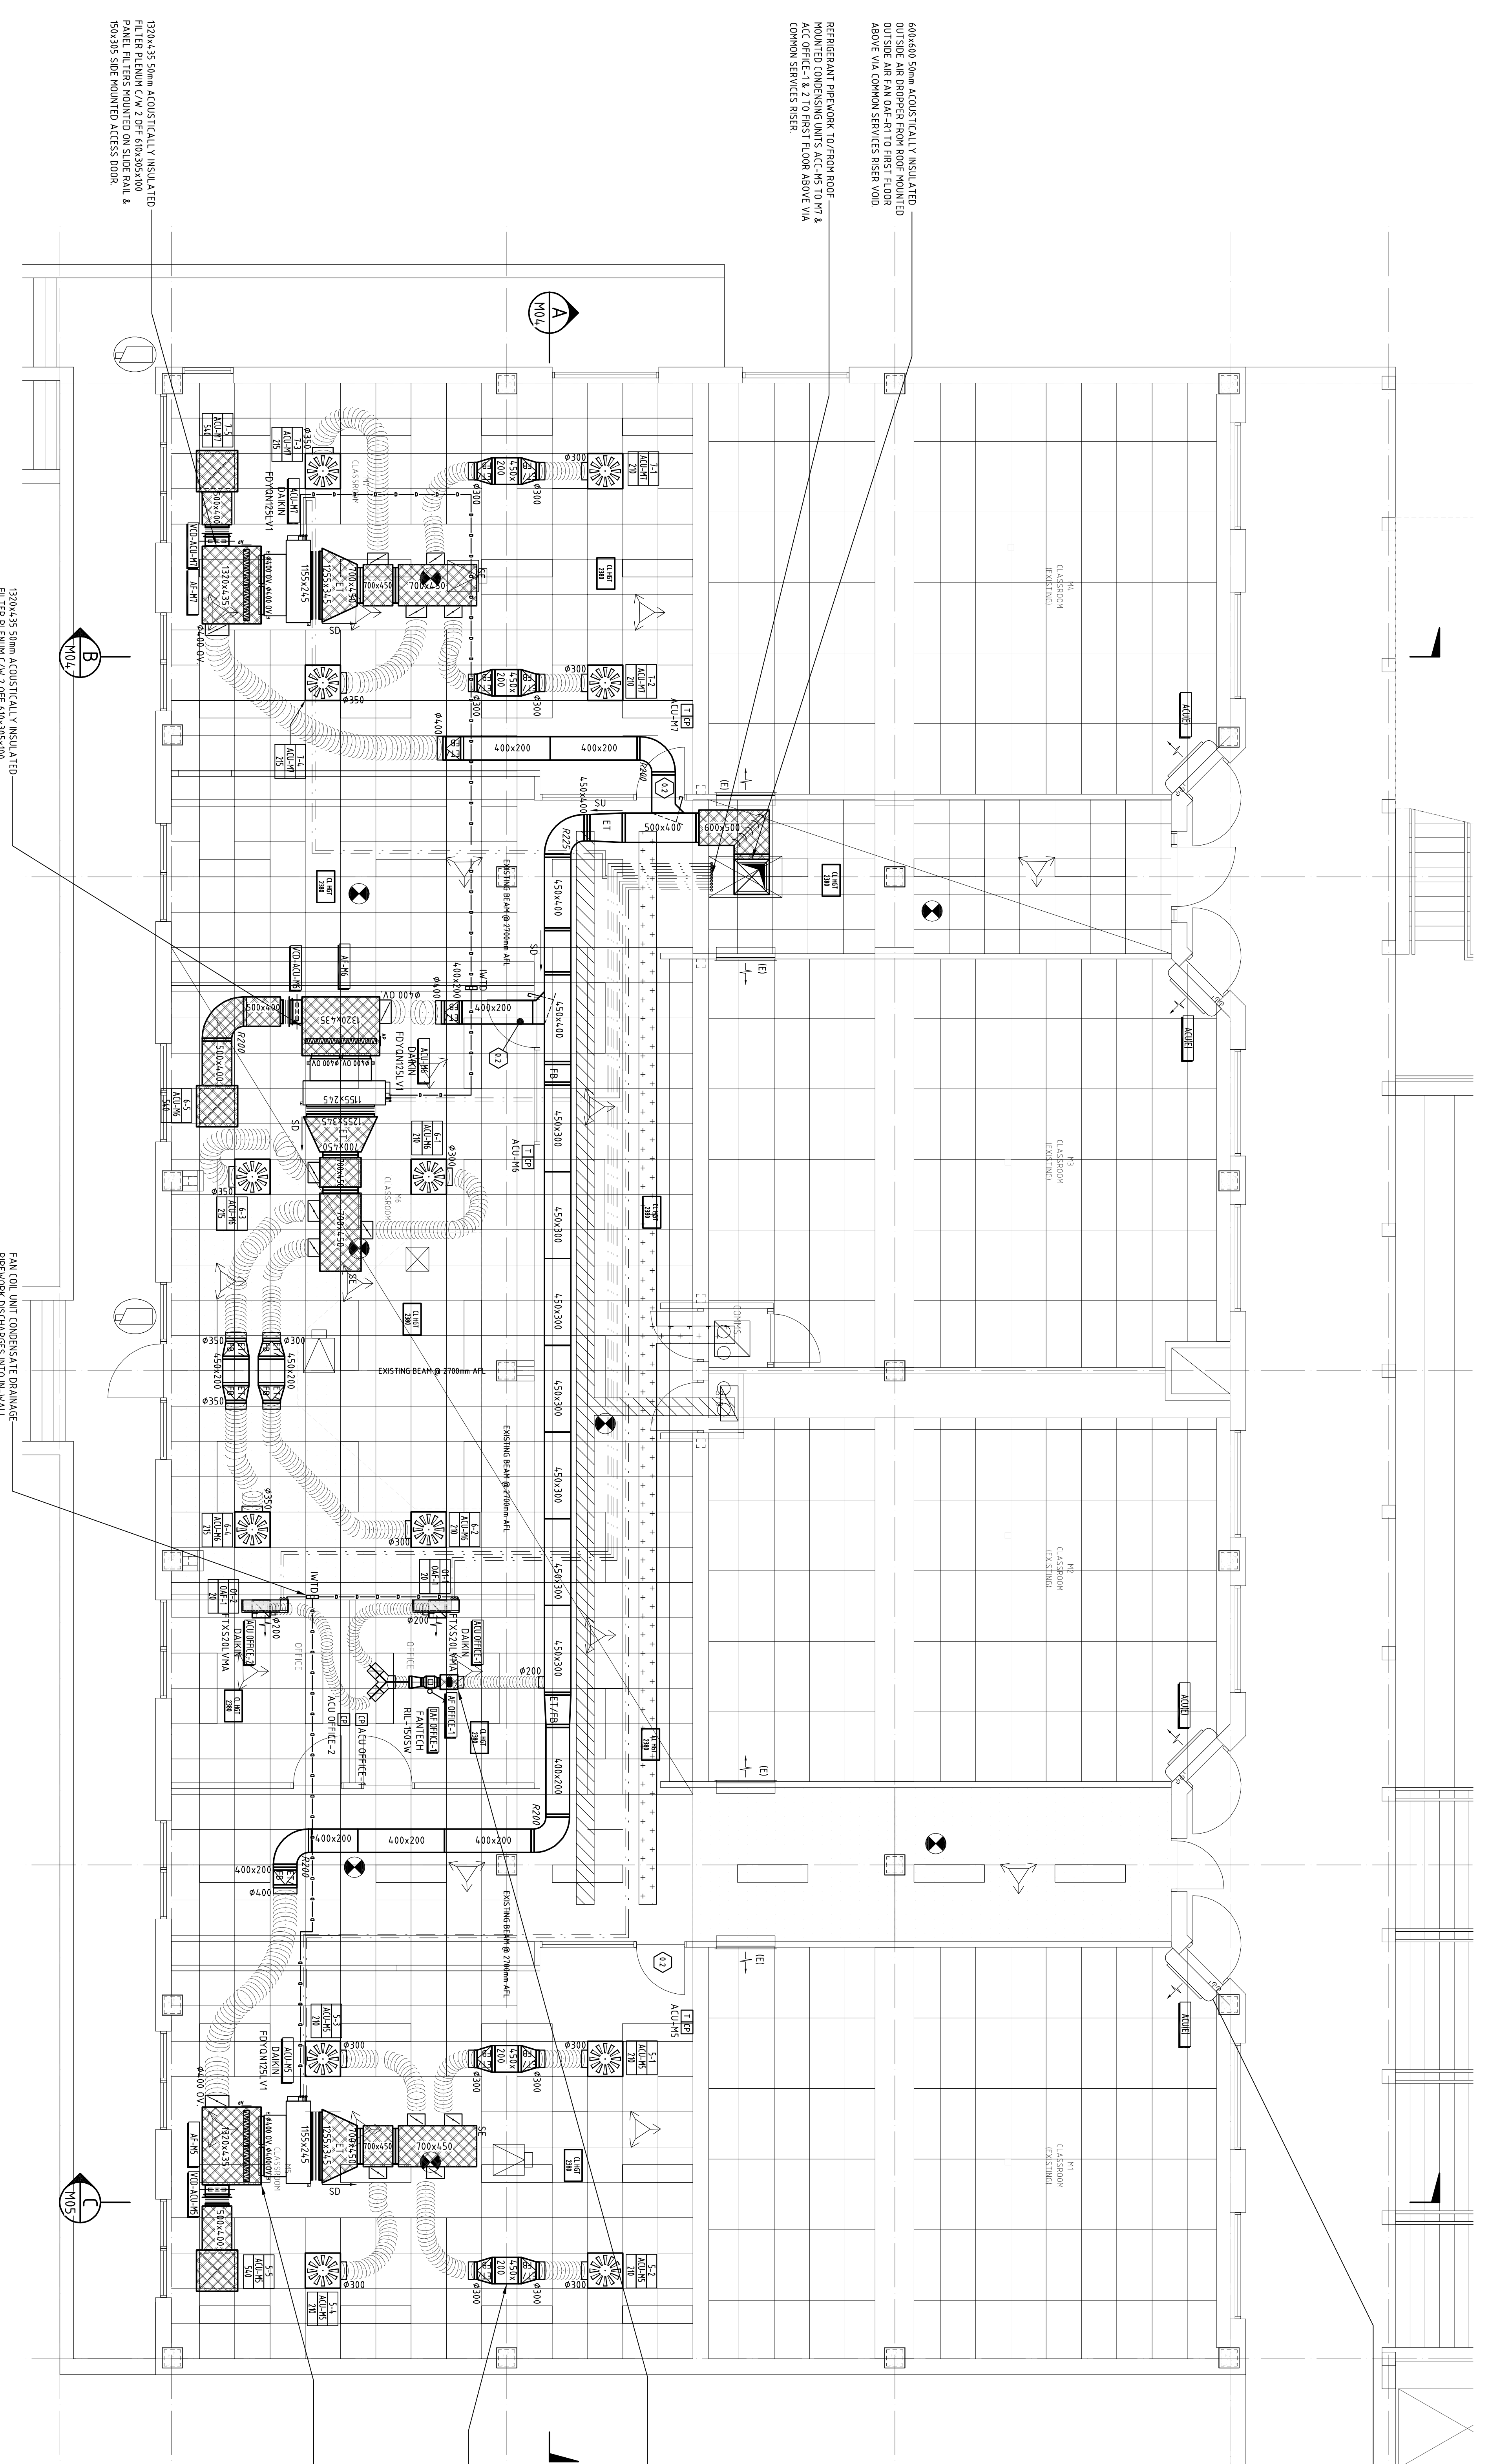

600x600 50mm ACOUSTICALLY INSULATED
OUTSIDE AIR FAN OFF-TO FIRST FLOOR
ABOVE VIA COMMON SERVICES RISER VOID.
REFRIGERANT PIPINGWORK TO/FROM ROOF-
MOUNTED CONDENSING UNITS ACCESS TO VIT &
ACCESS TO CONDENSING UNITS TO BE RETAINED
COMMON SERVICES RISER

150x200 50mm ACOUSTICALLY INSULATED
OUTSIDE AIR FAN OFF-TO FIRST FLOOR
ABOVE VIA COMMON SERVICES RISER VOID.
REFRIGERANT PIPINGWORK TO/FROM ROOF-
MOUNTED CONDENSING UNITS ACCESS TO VIT &
ACCESS TO CONDENSING UNITS TO BE RETAINED
COMMON SERVICES RISER

150x200 50mm ACOUSTICALLY INSULATED
OUTSIDE AIR FAN OFF-TO FIRST FLOOR
ABOVE VIA COMMON SERVICES RISER VOID.
REFRIGERANT PIPINGWORK TO/FROM ROOF-
MOUNTED CONDENSING UNITS ACCESS TO VIT &
ACCESS TO CONDENSING UNITS TO BE RETAINED
COMMON SERVICES RISER


FAN COIL UNIT CONDENSATE DRAINAGE
PIPEWORK DISCHARGES INTO IN-WALL
TUNNISH (TYPICAL)

150x200 50mm ACOUSTICALLY INSULATED
OUTSIDE AIR FAN OFF-TO FIRST FLOOR
ABOVE VIA COMMON SERVICES RISER VOID.
REFRIGERANT PIPINGWORK TO/FROM ROOF-
MOUNTED CONDENSING UNITS ACCESS TO VIT &
ACCESS TO CONDENSING UNITS TO BE RETAINED
COMMON SERVICES RISER

GROUND FLOOR - AIR CONDITIONING & VENTILATION ARRANGEMENT

SCALE 1:50

REV.	DESCRIPTION	BY	DATE
C	AS INSTALLED	ASR	13/02/14
B	ISSUED FOR APPROVAL	ASR	29/10/13
A	ISSUED FOR REVIEW & COMMENT	ASR	28/10/13
	AMENDMENT		

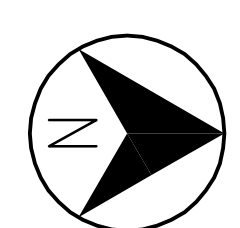

Project
**ST ALOYSIUS COLLEGE
MITCHELL BUILDING
ANGAS STREET, ADELAIDE 5000**

Client
INCA CONSTRUCTIONS

Sheet Title
**GROUND FLOOR
AIR CONDITIONING & VENTILATION
ARRANGEMENT**

Air Comfort Services
Air Conditioning Solutions

283 Cornook Road
South Australia, 5013
Adelaide
Telephone: 8388 5201
Fax: 8388 5201
Email: enquiries@aircomfortservices.com.au
www.aircomfortservices.com.au
o.c.n. 007 947 220

Drawn	Date	Scale	Sheet
ASR	13/02/14	1:50	B1

Drawing No. **CG116-M01**