


**SECTION A**  
SCALE 1:50

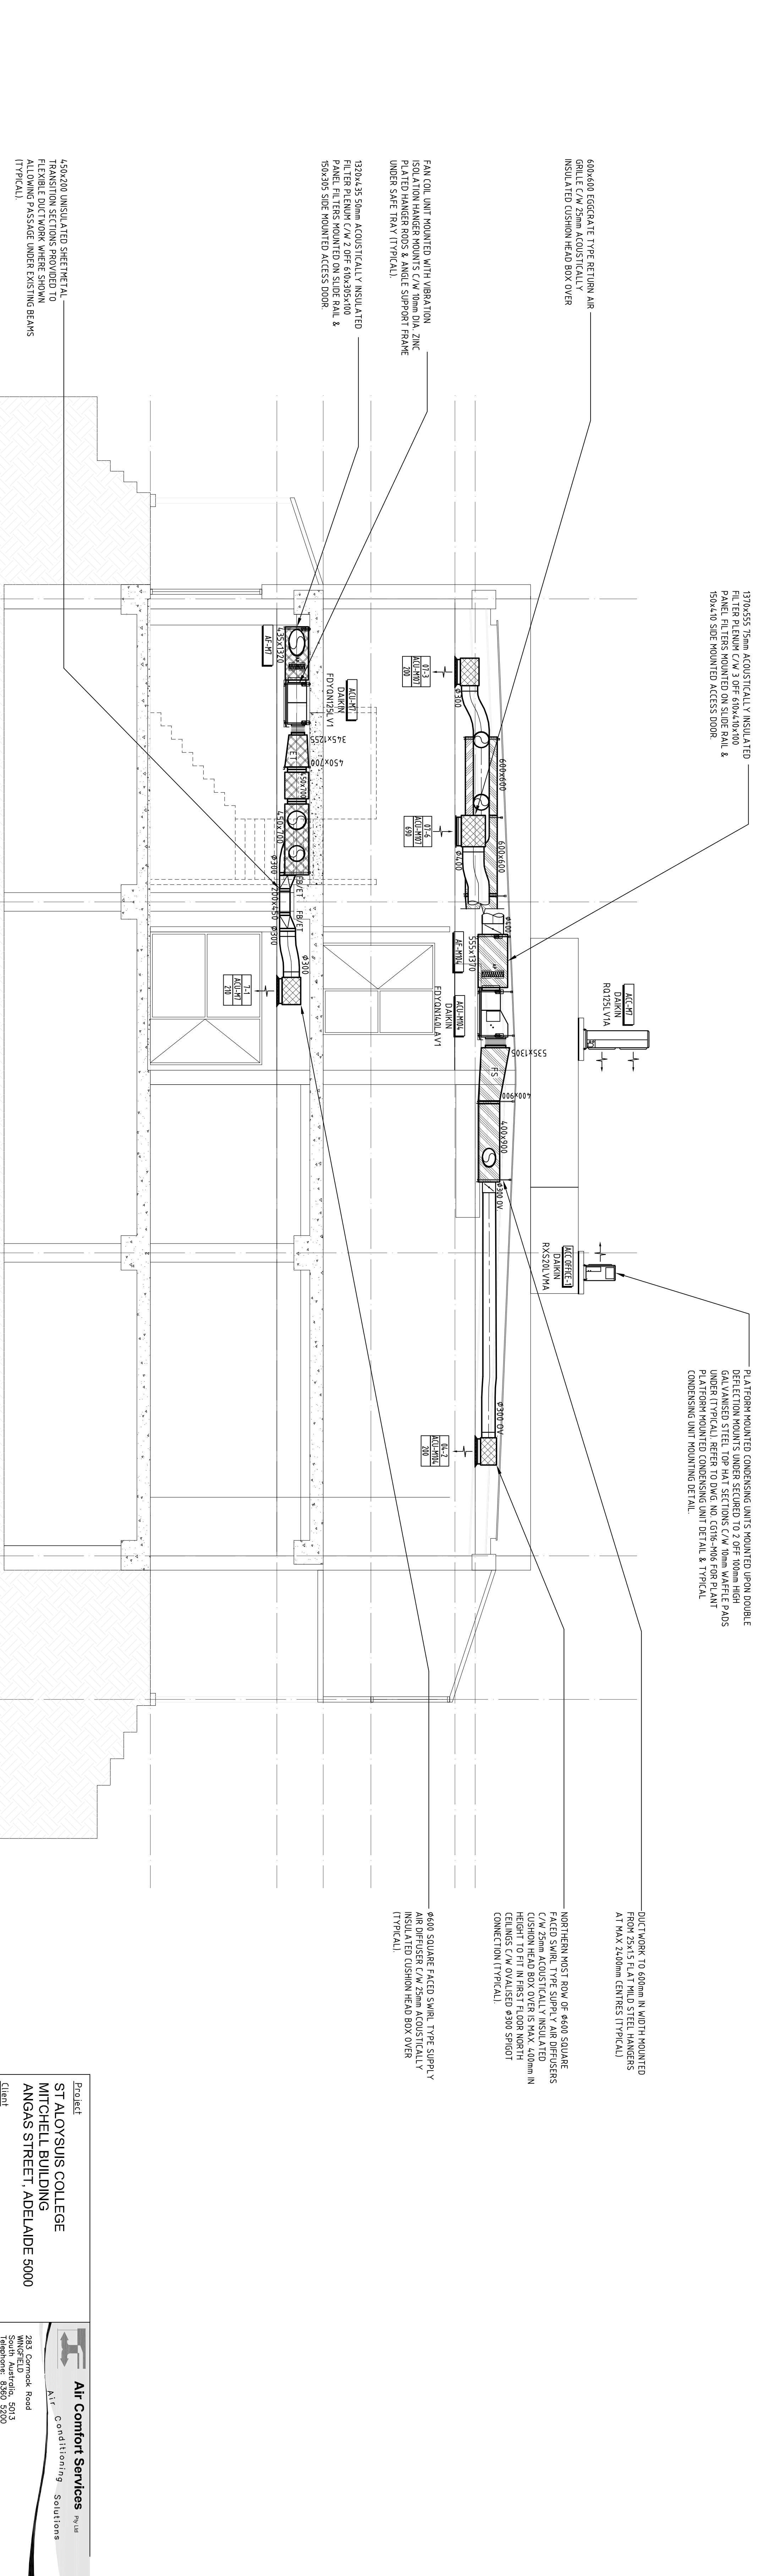

**SECTION B**  
SCALE 1:50

REV.	DESCRIPTION	BY	DATE
C	AS INSTALLED	ASR	13/02/14
B	ISSUED FOR APPROVAL	ASR	29/10/13
A	ISSUED FOR REVIEW & COMMENT	ASR	28/10/13
	AMENDMENT		

**Project**  
 ST ALOYSIUS COLLEGE  
 MITCHELL BUILDING  
 ANGAAS STREET, ADELAIDE 5000

**Client**  
 INCA CONSTRUCTIONS

233 Cornock Road  
 South Australia, 5013  
 Telephone: 8300 5201  
 Fax: 8300 5202  
 Email: enquiries@airconditioningsolutions.com.au  
 web: www.airconditioningsolutions.com.au  
 a.c.n. 007 947 220

**Air Comfort Services**  
 Air Conditioning Solutions

Drawing No. **CG116-M04**

Drawn	Date	Scale	Sheet
ASR	13/02/14	1:50	B1

Rev: **C**